


Scale: 1" = 40'

LEGEND

- TREE (yellow box) - ADDITIONAL TREE TO REMAIN BY RE-DESIGN (1:2 SLOPES)
- TREE (green circle) - TREES REMAINING IN ORIGINAL DESIGN
- (dashed blue line) - PROPOSED ADJUSTED LIMITS OF CONSTRUCTION (1:2 SLOPES)
- (dashed red line) - LOC - ORIGINAL LIMITS OF CONSTRUCTION (1:3 SLOPES)

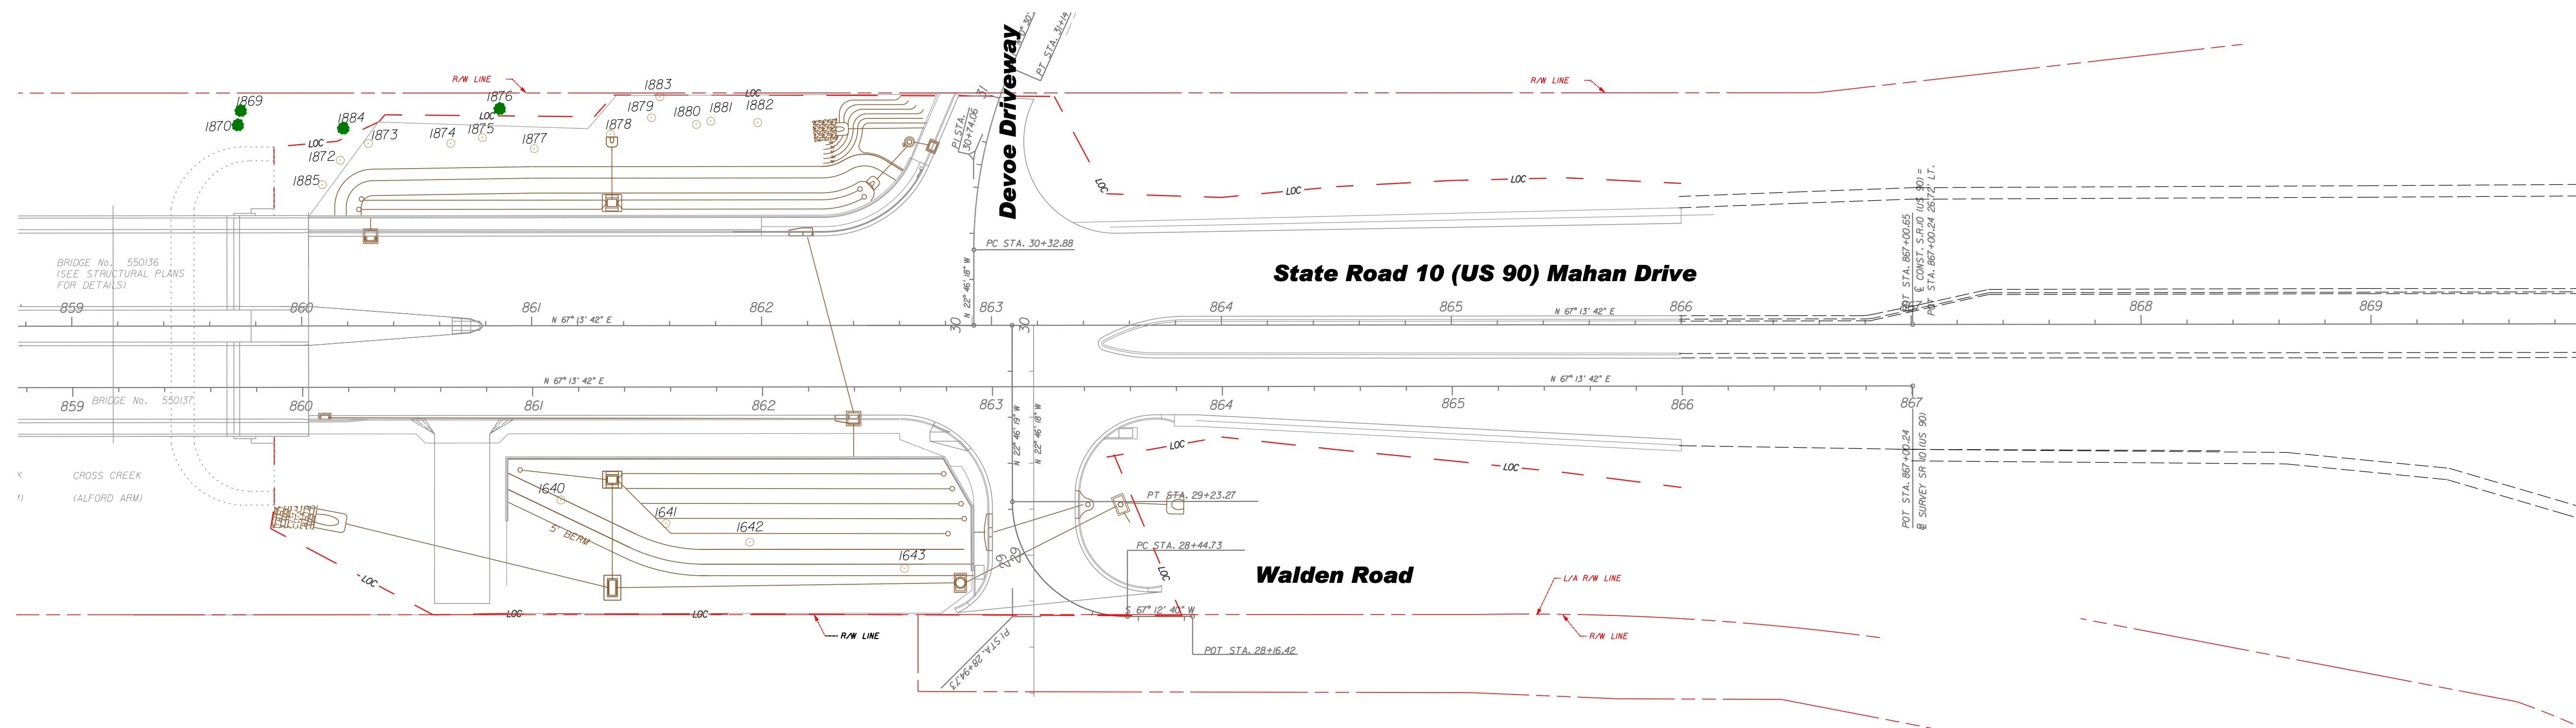

SR 10 (US 90) MAHAN DRIVE - TREE ANALYSIS